

SUBJECT TRACT

CS

RD

RMH

RM-1

AG

AG

RS-3

RS-3

IL



BOA-22884

4.1

20-13 17



**BOARD OF ADJUSTMENT
CASE REPORT**

STR: 207 Case Number: **BOA-22884**

CZM: 22

CD: 1

HEARING DATE: 06/23/2020 1:00 PM (*Continued from 06/09/2020*)

APPLICANT: Brandon Ledezma

ACTION REQUESTED: Variance of required 5 foot side yard setback in an RS-3 district (Section 5.030, Table 5-3)

LOCATION: 4408 N DELAWARE AV E

ZONED: RS-3

PRESENT USE: Residential

TRACT SIZE: 20908.89 SQ FT

LEGAL DESCRIPTION: BEG 30W & 123.3N SECR N/2 NE SE NW TH N126.7 W144.24 S122 E144.32 POB SEC 17 20 13 .412AC

RELEVANT PREVIOUS ACTIONS: None.

RELATIONSHIP TO THE COMPREHENSIVE PLAN: The Tulsa Comprehensive Plan identifies the subject property as part of an "Existing Neighborhood " and an "Area of Growth".

An **Existing Neighborhood** is intended to preserve and enhance Tulsa's existing single-family neighborhoods. Development activities in these areas should be limited to the rehabilitation, improvement or replacement of existing homes, and small-scale infill projects, as permitted through clear and objective setback, height, and other development standards of the zoning code.

The purpose of **Areas of Growth** is to direct the allocation of resources and channel growth to where it will be beneficial and can best improve access to jobs, housing, and services with fewer and shorter auto trips. Areas of Growth are parts of the city where general agreement exists that development or redevelopment is beneficial. As steps are taken to plan for, and, in some cases, develop or redevelop these areas, ensuring that existing residents will not be displaced is a high priority. A major goal is to increase economic activity in the area to benefit existing residents and businesses, and where necessary, provide the stimulus to redevelop.

ANALYSIS OF SURROUNDING AREA: The subject tract is located South of the SW/c N. Delaware Ave. and E. 44th St. N.

STAFF COMMENTS: The Applicant is requesting **Variance** of required 5 foot side yard setback in an RS-3 district (Section 5.030, Table 5-3)

Table 5-3: R District Lot and Building Regulations

Regulations	RE	RS-1	RS-2	RS-3	RS-4	RS-5	RD	RT	RM-0	RM-1	RM-2	RM-3	RMH
Min. Building Setbacks (ft.)													
Street [3]													
Arterial or fwy service rd.	35	35	35	35	35	35	35	35	35	35	35	35	35
Other streets	35	35	30	25	20	20	25	10	25	25	10	25	25
Side (interior) [4]	15	5	5	5	5	5	5	5[5]	5[6]	5[6]	5[6]	5[7]	10
Rear [4]	25	25	25	20	20	20	20	20	20	20	10	20	15

Per the site plan provided the the structure was built 2.5” away from the side property line.

STATEMENT OF HARSDHIP: The reason we built this porch there is because there use to be an old garage there. The garage was 1 ft away from the property line, so we thought it was right for us to build so close to the property line. In front of the house there are sewer lines and natural gas. On the north side there are buried electric lines as well. We have our own company and we have all our equipment and truck so we built it so that when it rained our equipment wouldn’t be damaged.

SAMPLE MOTION: Move to _____ (approve/deny) a **Variance** of required 5 foot side yard setback in an RS-3 district (Section 5.030, Table 5-3)

- Finding the hardship(s) to be _____.
- Per the Conceptual Plan(s) shown on page(s) _____ of the agenda packet.
- Subject to the following conditions _____.

In granting the **Variance** the Board finds that the following facts, favorable to the property owner, have been established:

- That the physical surroundings, shape, or topographical conditions of the subject property would result in unnecessary hardships or practical difficulties for the property owner, as distinguished from a mere inconvenience, if the strict letter of the regulations were carried out;*
- That literal enforcement of the subject zoning code provision is not necessary to achieve the provision’s intended purpose;*
- That the conditions leading to the need of the requested variance are unique to the subject property and not applicable, generally, to other property within the same zoning classification;*
- That the alleged practical difficulty or unnecessary hardship was not created or self-imposed by the current property owner;*
- That the variance to be granted is the minimum variance that will afford relief;*
- That the variance to be granted will not alter the essential character of the neighborhood in which the subject property is located, nor substantially or permanently impair use or development of adjacent property; and*
- That the variance to be granted will not cause substantial detriment to the public good or impair the purposes, spirit, and intent of this zoning code or the comprehensive plan.”*



Facing North on Delaware



Facing South on Delaware



Subject property




Subject Property



122 ft

TOP VIEW

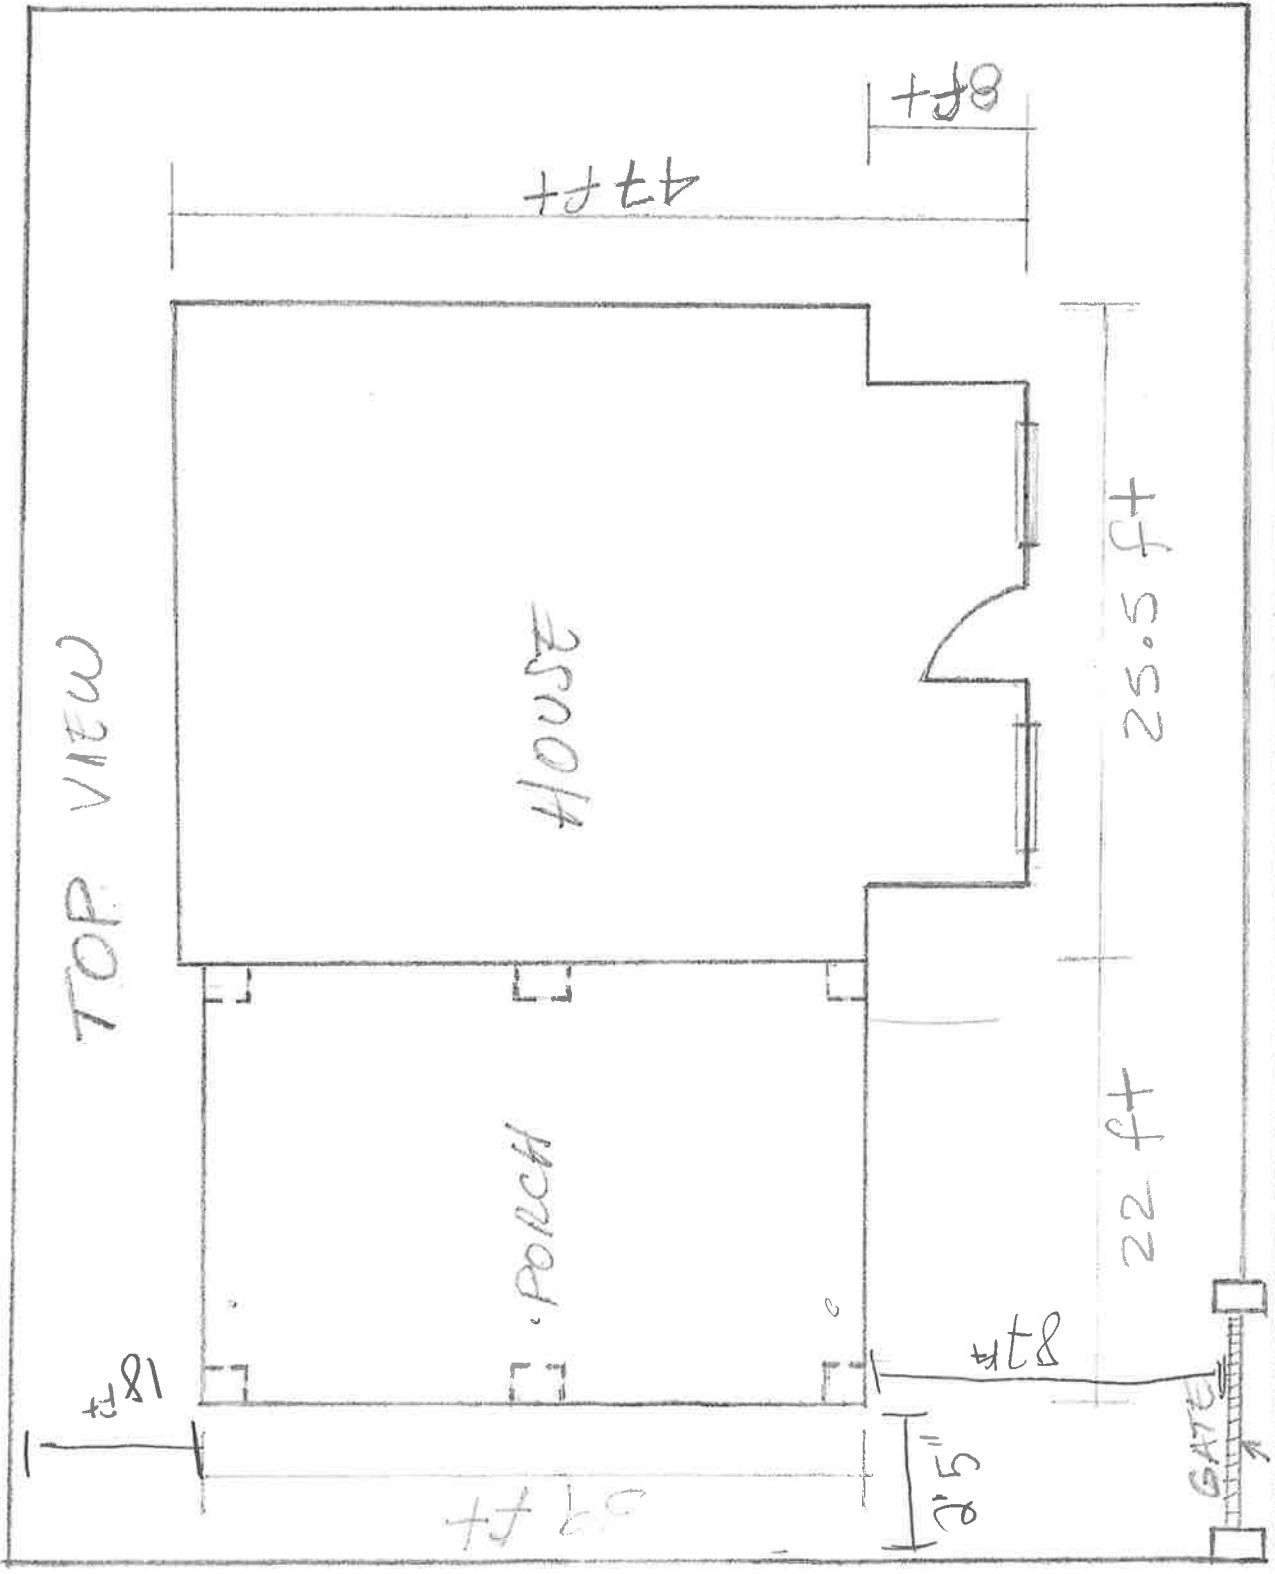

HOUSE

PORCH

47 ft

25.5 ft

22 ft

18 ft

49 ft

8 ft

5 ft


8 ft

STREET

149.24 ft

9.6

PORCH TOP VIEW

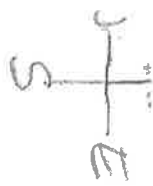

22' 8"

2" x 12"

2' OFF
OF FACE

COLUMN
20"

19'

17' 3"
18' 10"


39'

112"


64" 64" 64" 64"

ENTRANCE A

4.7

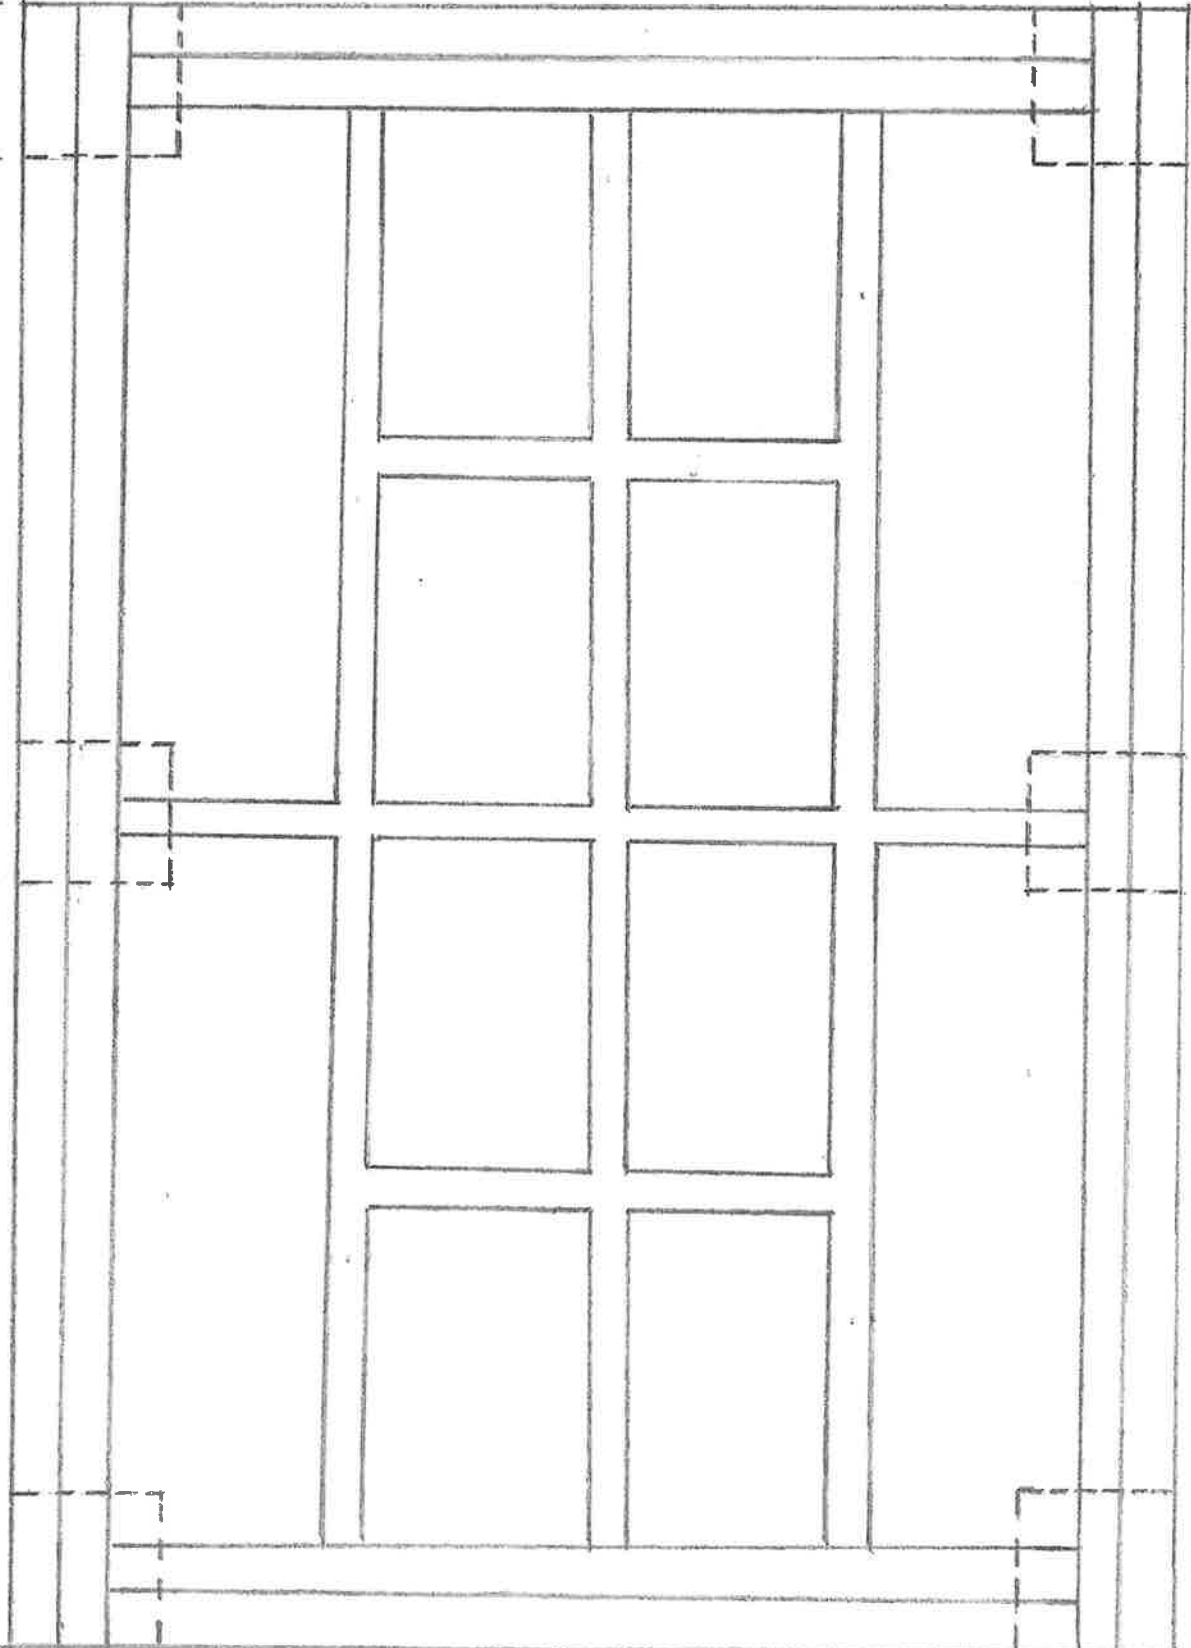

PORCH FRONT VIEW

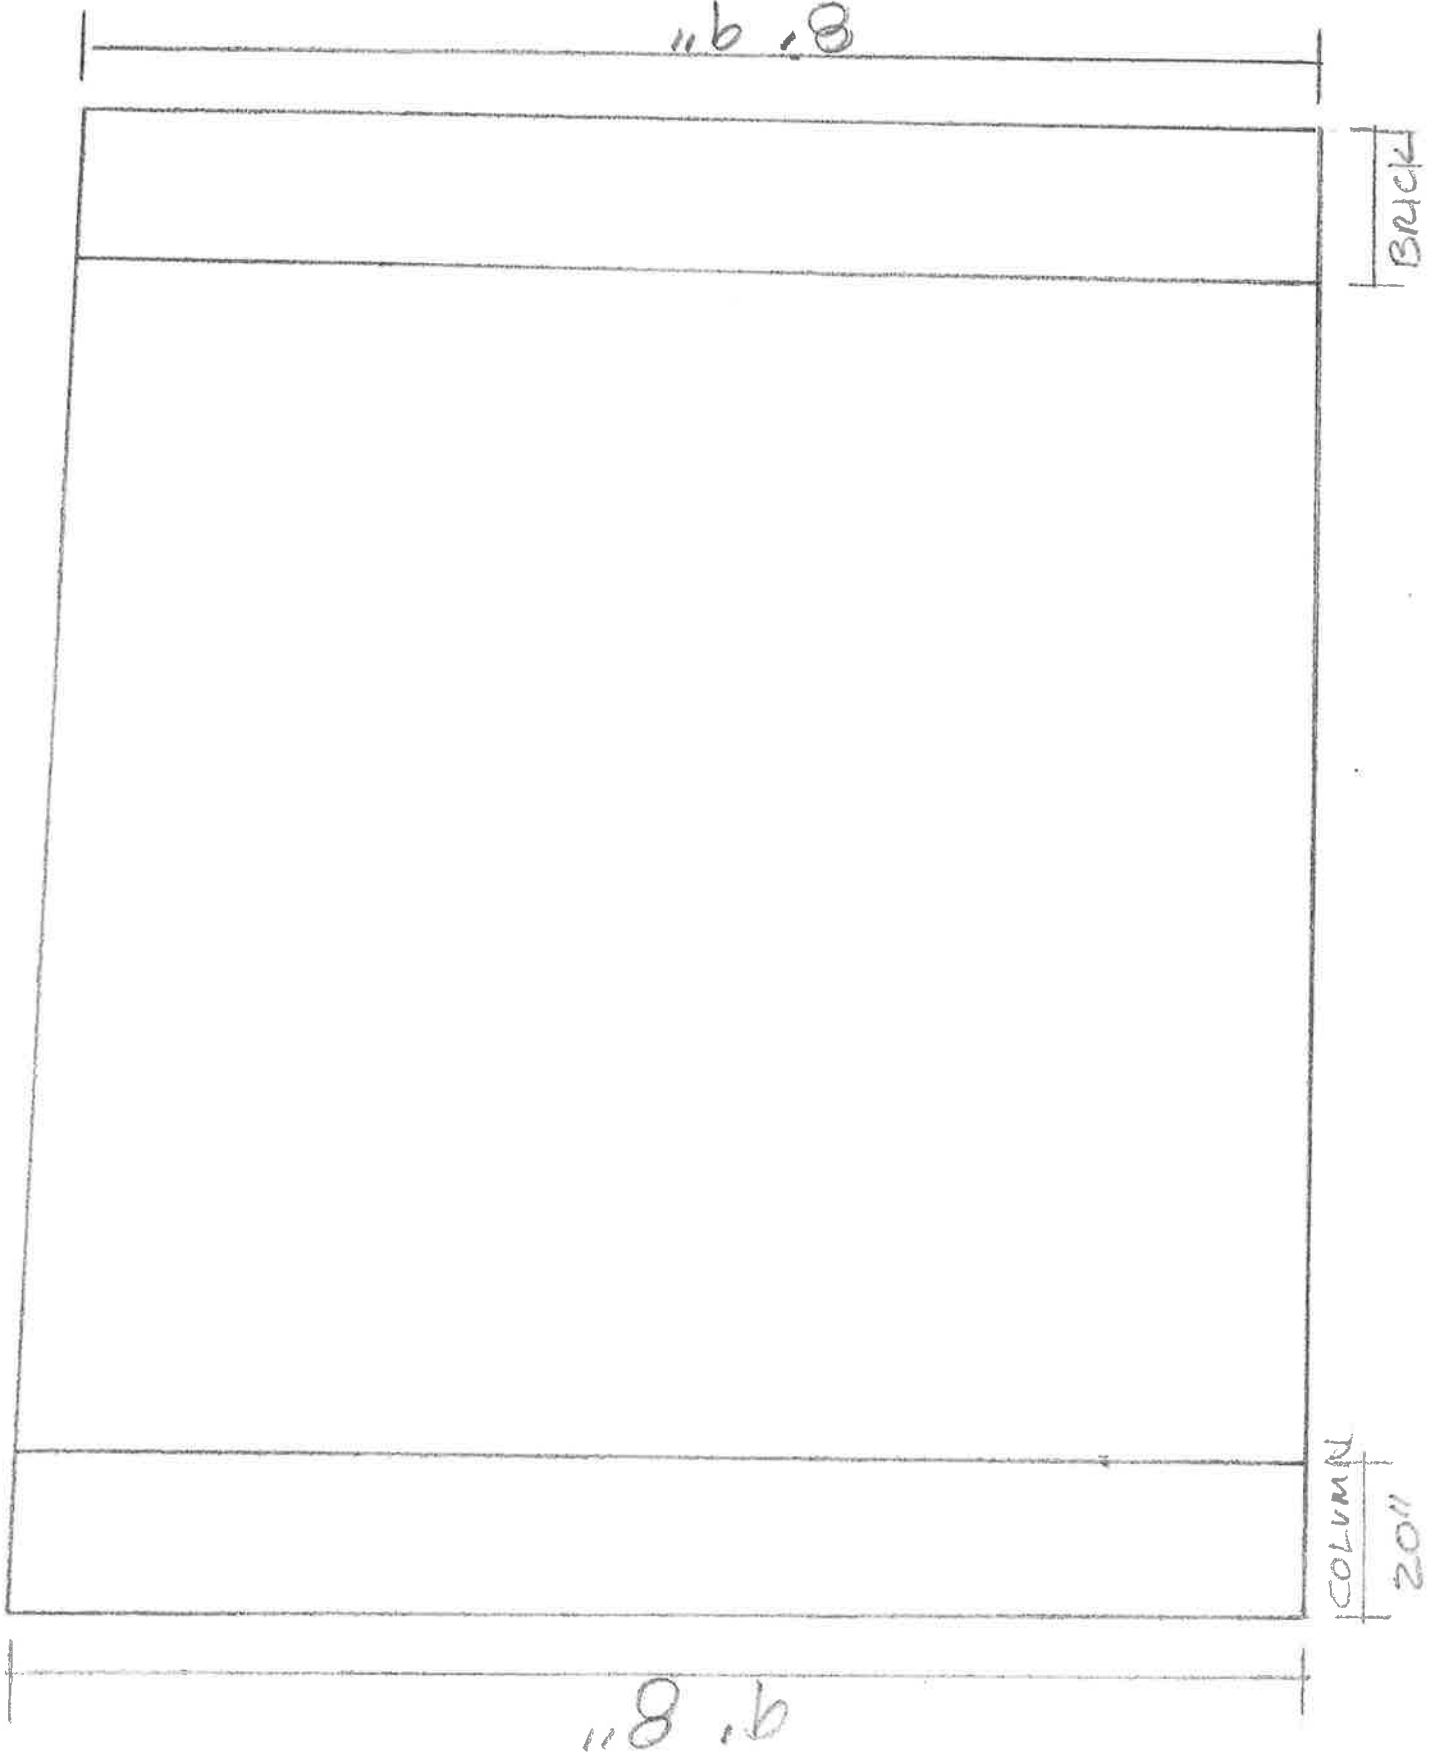

Metal Sheeting

metal rafters
2x8

wooden
4x12 beam

11.8

4.5


18.6

11.8

concrete slab

Front side

22

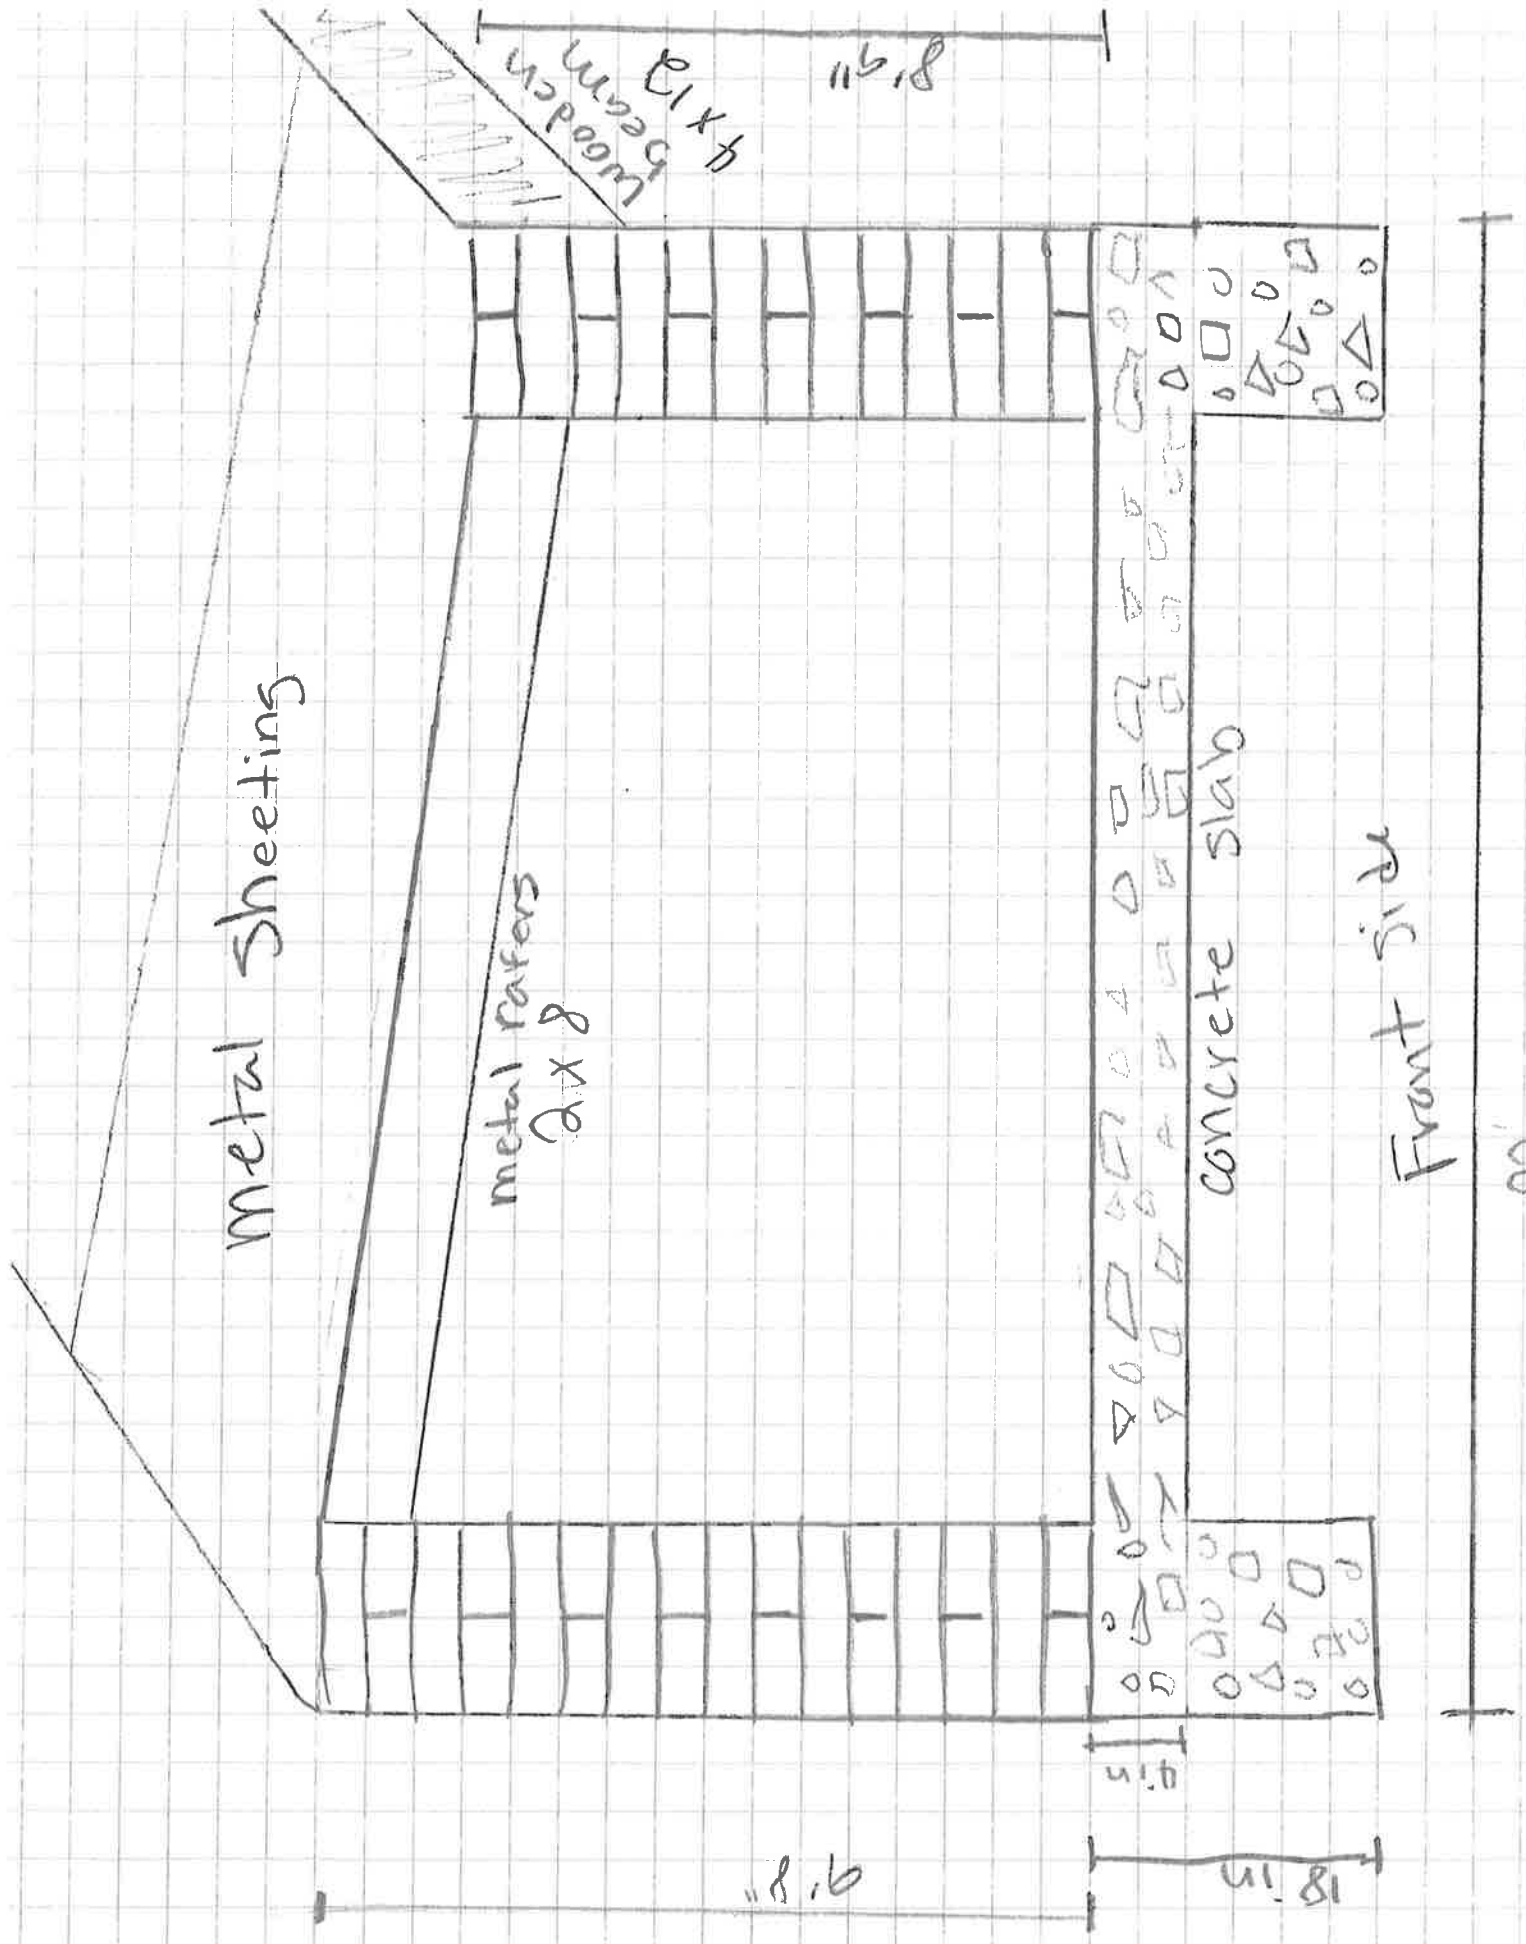



39'

Right Side

Wooden beam





Wooden beam

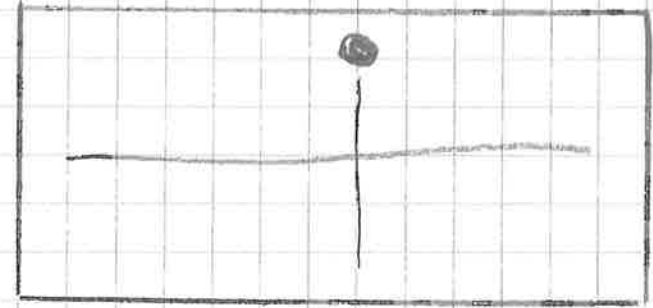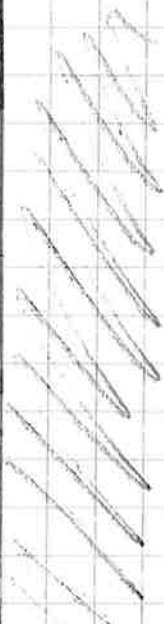

House



House wall

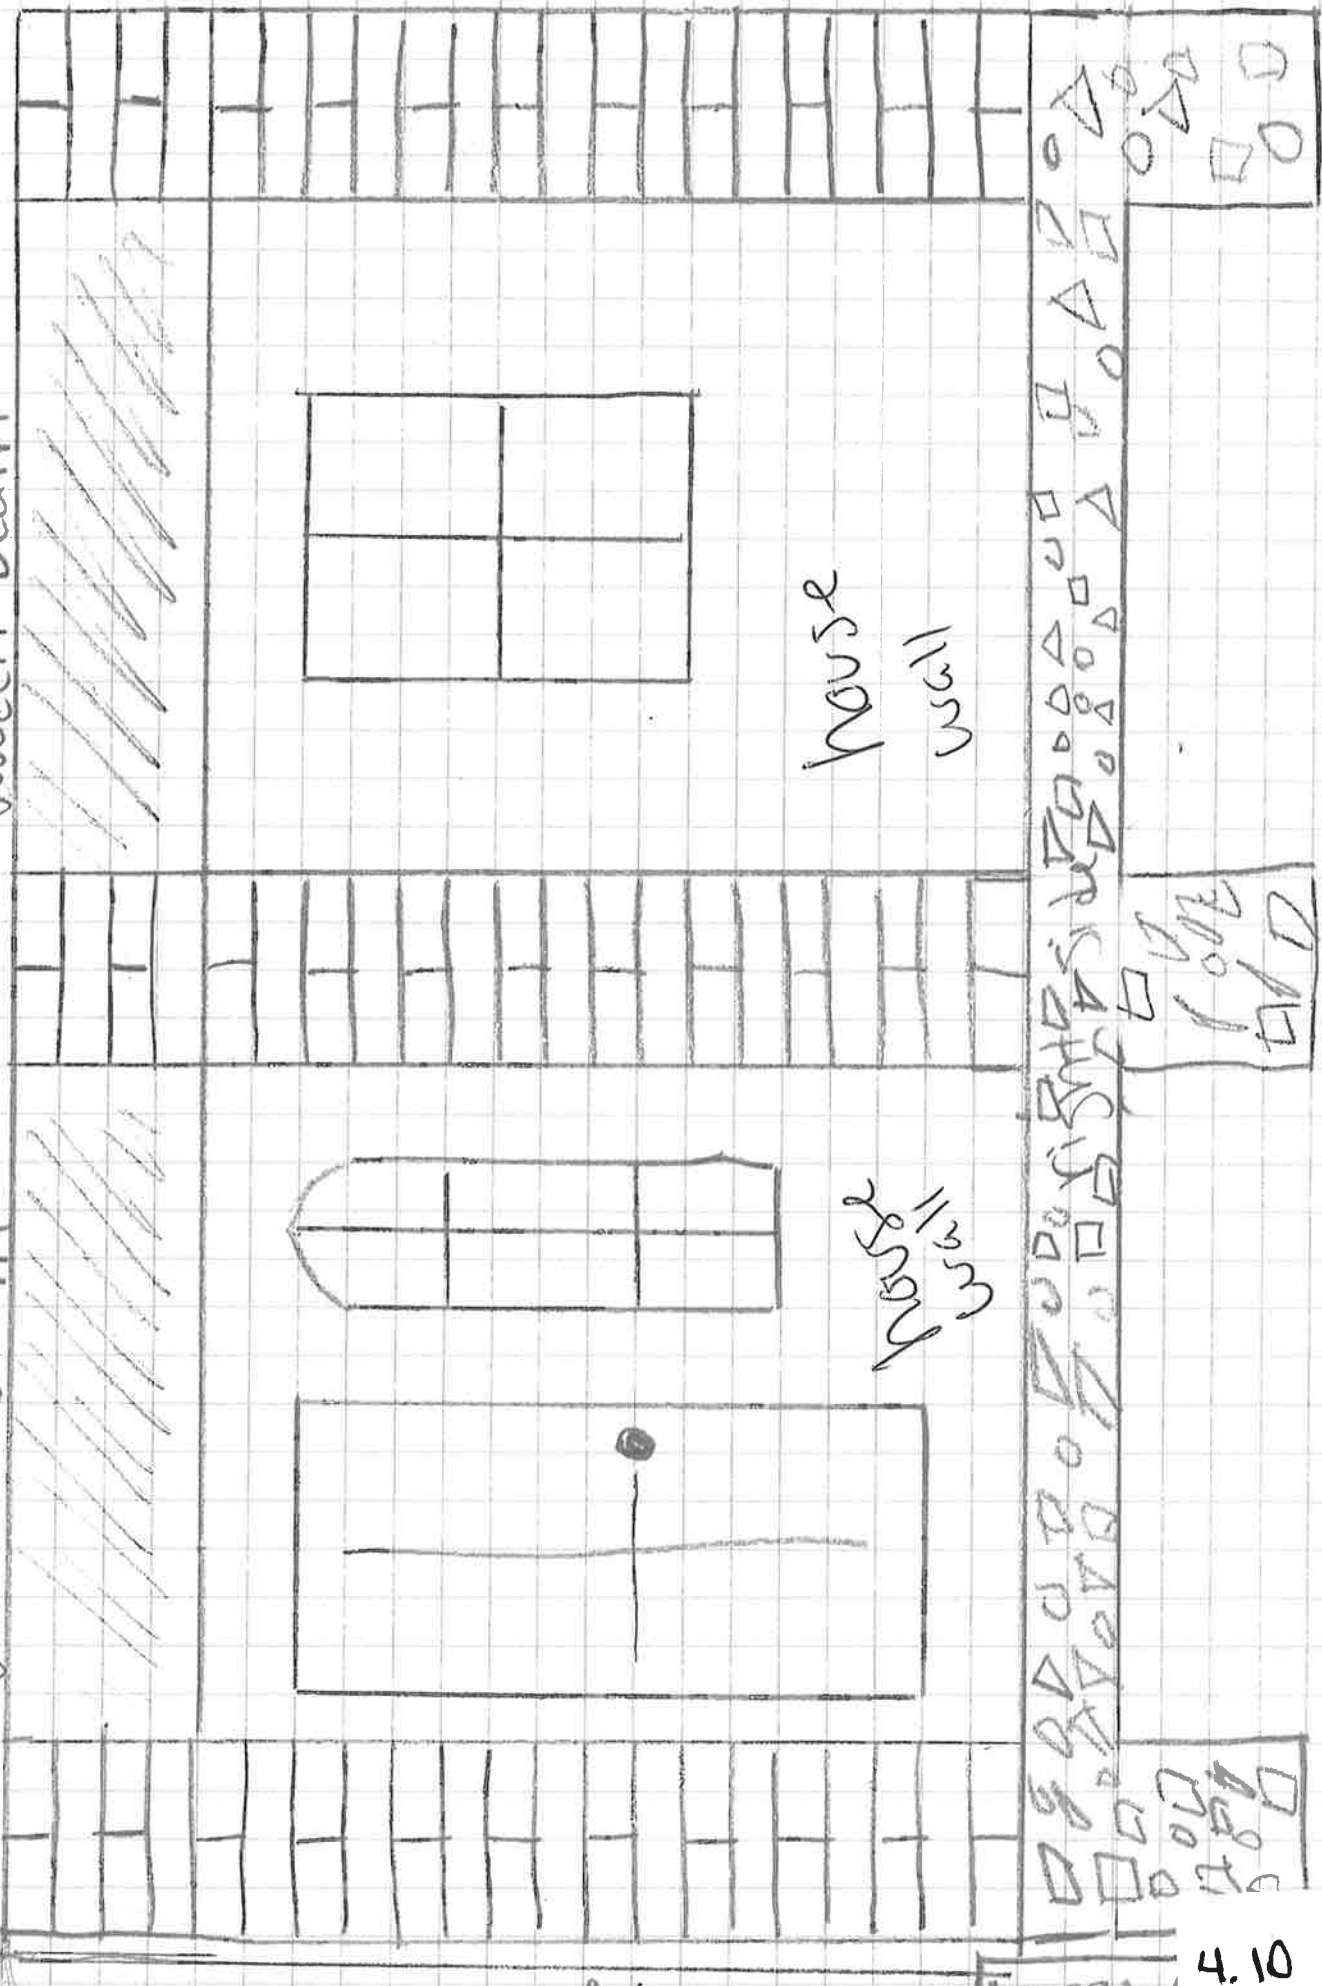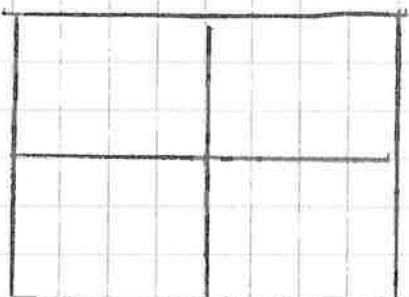

left side

right

wooden beam

wooden beam



Stucco



Window

4.11

0

0

4.11

back side

22 ft

8.6


metal beam
2x8 Rafter


concrete slab

5.8

4.12

4.81

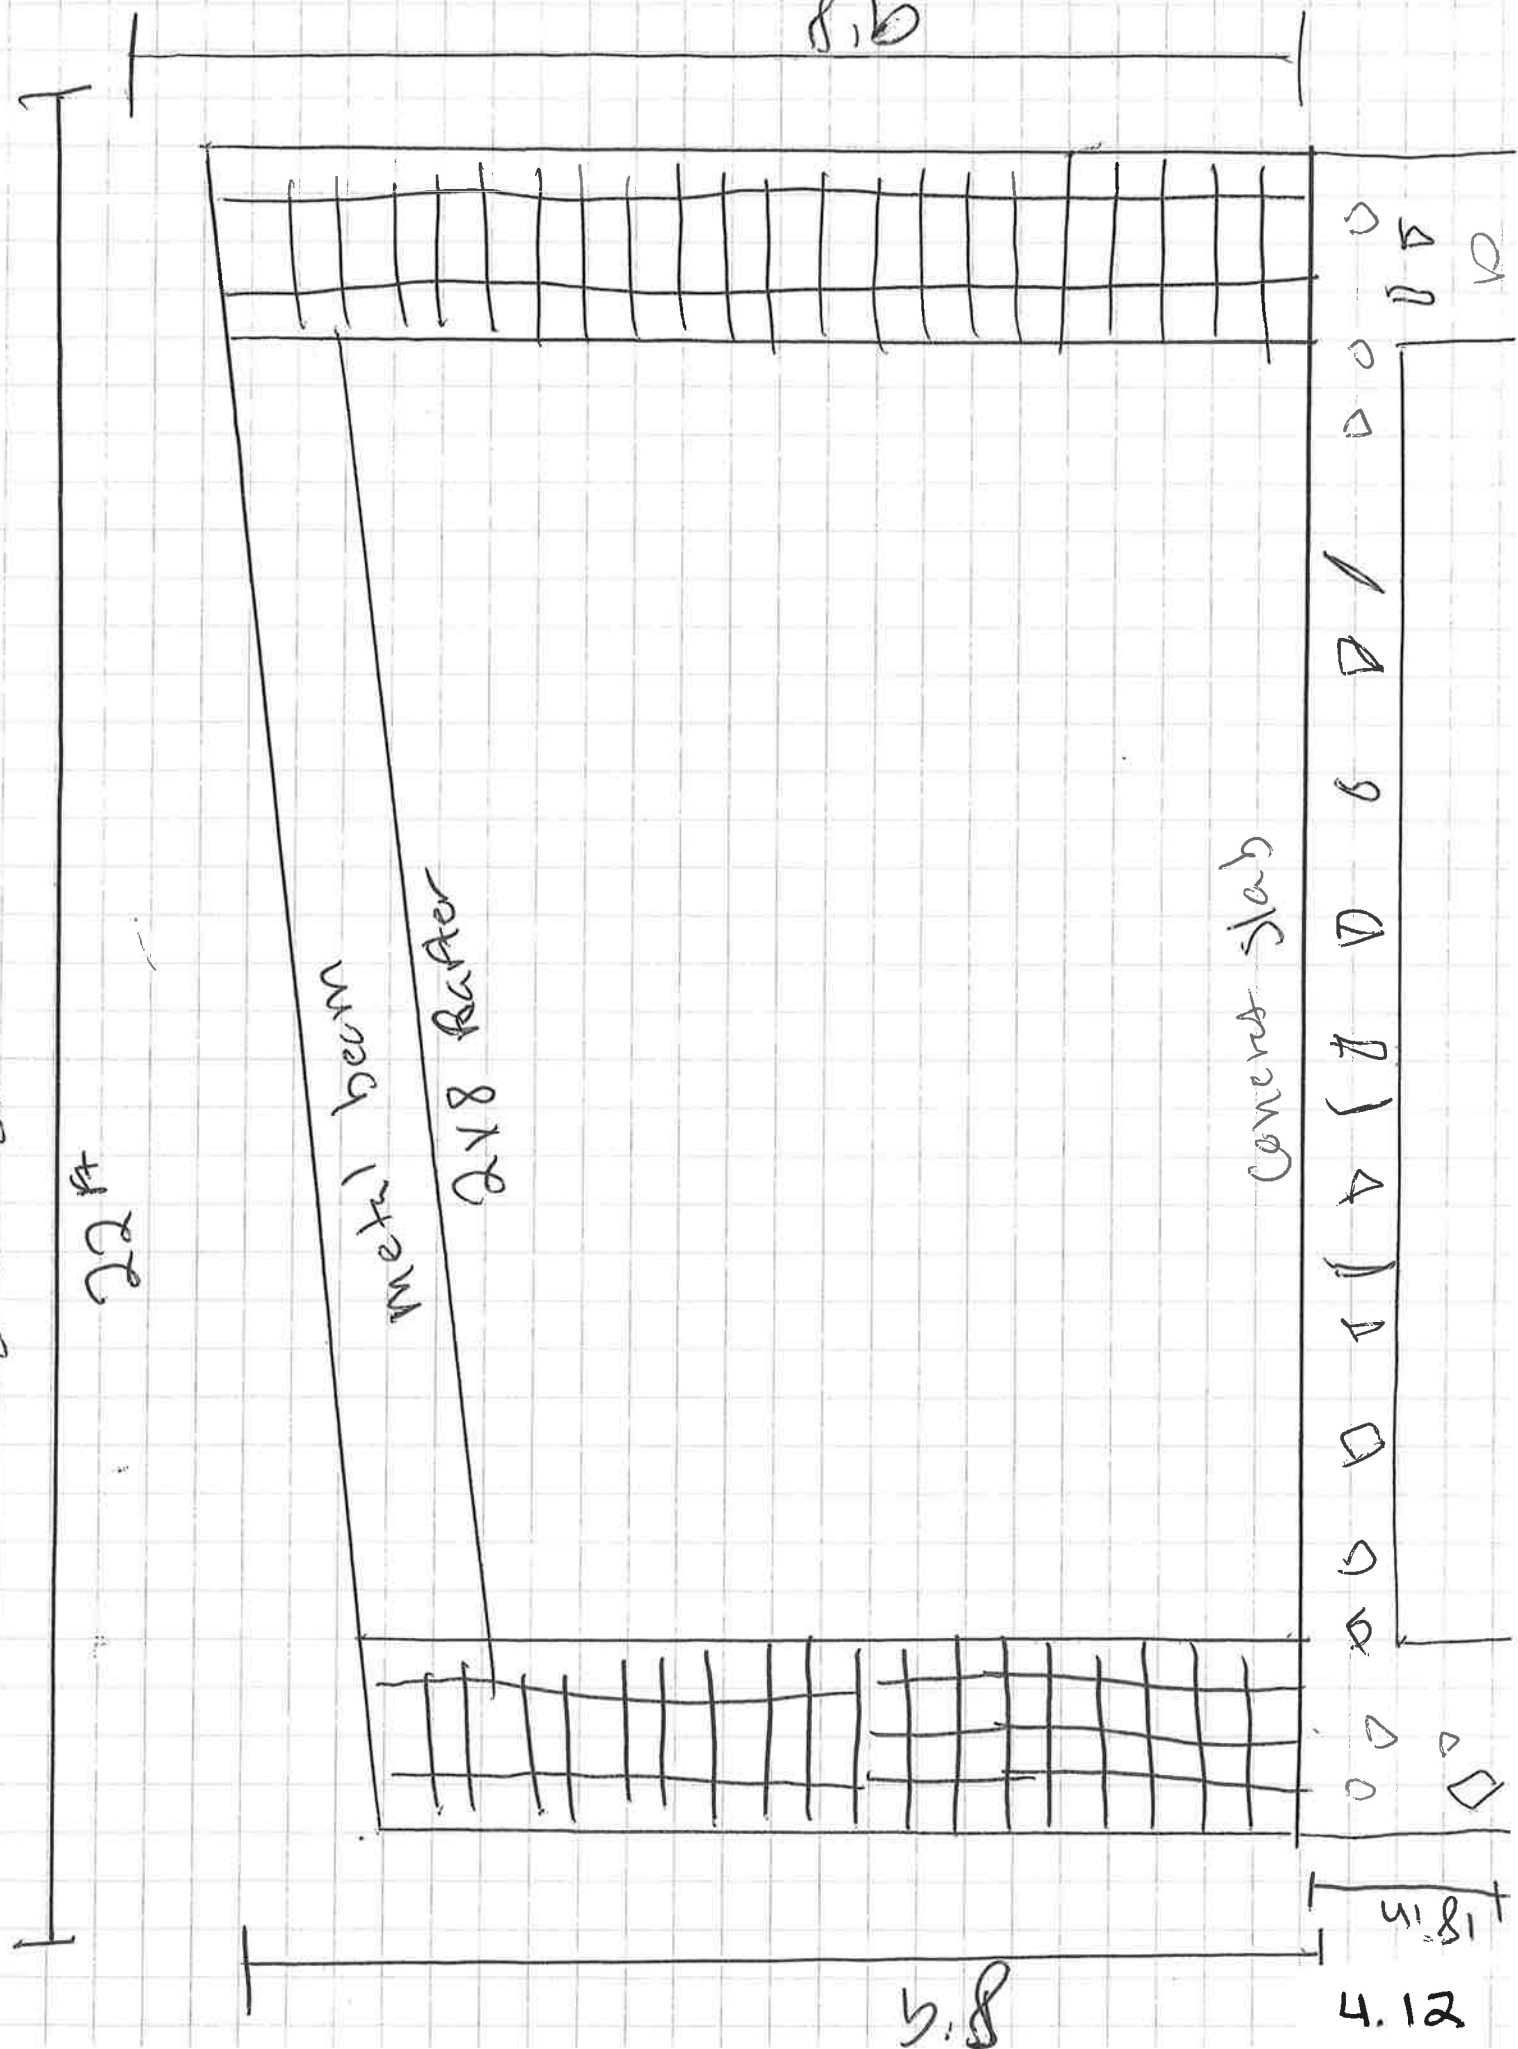

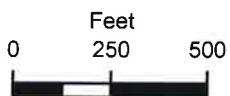

Subject Tract

BOA-22884

Note: Graphic overlays may not precisely align with physical features on the ground.

20-13 17

Aerial Photo Date: February 2018



4.13



E 44 PL N

N DELAWARE AVE

E 44 ST N

E 43 ST N

E 42 PL N



Subject Tract

BOA-22884

20-13 17

Note: Graphic overlays may not precisely align with physical features on the ground.

Aerial Photo Date: February 2018



4.14

Jeff S. Taylor
Zoning Official
Plans Examiner III
TEL(918) 596-7637
jstaylor@cityoftulsa.org



DEVELOPMENT SERVICES
175 EAST 2nd STREET, SUITE 450
TULSA, OKLAHOMA 74103

ZONING CLEARANCE PLAN REVIEW

Brandon Ledezma
brandonledezma98@gmail.com

1/18/2020

APPLICATION NO: BLDR-50998-2019 (PLEASE REFERENCE THIS NUMBER WHEN CONTACTING OUR OFFICE)

Project Location: 4408 N Delaware Ave E

Description: Carport

INFORMATION ABOUT SUBMITTING REVISIONS

OUR REVIEW HAS IDENTIFIED THE FOLLOWING CODE OMISSIONS OR DEFICIENCIES IN THE PROJECT APPLICATION FORMS, DRAWINGS, AND/OR SPECIFICATIONS. THE DOCUMENTS SHALL BE REVISED TO COMPLY WITH THE REFERENCED CODE SECTIONS.

REVISIONS NEED TO INCLUDE THE FOLLOWING:

1. A COPY OF THIS DEFICIENCY LETTER
2. A WRITTEN RESPONSE AS TO HOW EACH REVIEW COMMENT HAS BEEN RESOLVED
3. THE COMPLETED REVISED/ADDITIONAL PLANS FORM (SEE ATTACHED)
4. BOARD OF ADJUSTMENT APPROVAL DOCUMENTS, IF RELEVANT

REVISIONS SHALL BE SUBMITTED DIRECTLY TO THE CITY OF TULSA PERMIT CENTER LOCATED AT 175 EAST 2nd STREET, SUITE 450, TULSA, OKLAHOMA 74103, PHONE (918) 596-9601. THE CITY OF TULSA WILL ASSESS A RESUBMITTAL FEE. DO NOT SUBMIT REVISIONS TO THE PLANS EXAMINERS.

SUBMITTALS FAXED / EMAILED TO PLANS EXAMINERS WILL NOT BE ACCEPTED.

IMPORTANT INFORMATION

1. SUBMIT TWO (2) SETS [4 SETS IF HEALTH DEPARTMENT REVIEW IS REQUIRED] OF REVISED OR ADDITIONAL PLANS. REVISIONS SHALL BE IDENTIFIED WITH CLOUDS AND REVISION MARKS.
2. INFORMATION ABOUT ZONING CODE, INDIAN NATION COUNCIL OF GOVERNMENT (INCOG), BOARD OF ADJUSTMENT (BOA), AND TULSA METROPOLITAN AREA PLANNING COMMISSION (TMAPC) IS AVAILABLE ONLINE AT WWW.INCOG.ORG OR AT INCOG OFFICES AT 2 W. 2nd ST., 8th FLOOR, TULSA, OK, 74103, PHONE (918) 584-7526.
3. A COPY OF A "RECORD SEARCH" IS IS NOT INCLUDED WITH THIS LETTER. PLEASE PRESENT THE "RECORD SEARCH" ALONG WITH THIS LETTER TO INCOG STAFF AT TIME OF APPLYING FOR BOARD OF ADJUSTMENT ACTION AT INCOG. UPON APPROVAL BY THE BOARD OF ADJUSTMENT, INCOG STAFF WILL PROVIDE THE APPROVAL DOCUMENTS TO YOU FOR IMMEDIATE SUBMITTAL TO OUR OFFICE. (See revisions submittal procedure above.).

(continued)

REVIEW COMMENTS

SECTIONS REFERENCED BELOW ARE FROM THE CITY OF TULSA ZONING CODE TITLE 42 AND CAN BE VIEWED AT WWW.CITYOFTULSA-BOA.ORG

Application No. **BLDR-50998-2019**

Note: As provided for in Section 70.130 you may request the Board of Adjustment to grant a variance from the terms of the Zoning Code requirements identified in the letter of deficiency below. Please direct all questions concerning variances, special exceptions, appeals of an administrative official decision, Master Plan Developments Districts (MPD), Planned Unit Developments (PUD), Corridor (CO) zoned districts, zoning changes, platting, lot splits, lot combinations, alternative compliance landscape and screening plans and all questions regarding (BOA) or (TMAPC) application forms and fees to an INCOG representative at 584-7526. It is your responsibility to submit to our offices documentation of any appeal decisions by an authorized decision making body affecting the status of your application so we may continue to process your application. INCOG does not act as your legal or responsible agent in submitting documents to the City of Tulsa on your behalf.

Staff review comments may sometimes identify compliance methods as provided in the Tulsa Zoning Code. The permit applicant is responsible for exploring all or any options available to address the noncompliance and submit the selected compliance option for review. Staff review makes neither representation nor recommendation as to any optimal method of code solution for the project.

5.030-A: In the RS-3 zoned district the minimum side yard setback shall be 5 feet from the side property line.

Review Comments: Revise your plans to indicate a 5' side setback from carport to the property line, or apply to INCOG for a variance to allow less than a 5' side setback.

55.090-F Surfacing. All off-street parking areas must be surfaced with a dustless, all-weather surface unless otherwise expressly stated in this zoning code. Pervious pavement or pervious pavement systems are allowed subject to the supplemental regulations of §55.090-F4. Parking area surfacing must be completed prior to initiation of the use to be served by the parking.

Review Comments: Provide a dustless all-weather parking surface from the public street to and under the proposed carport or apply to the Board of Adjustment for a Variance (section 70.120) to allow a material other than an approved material meeting the requirements of 55.090-F.

This letter of deficiencies covers Zoning plan review items only. You may receive additional letters from other disciplines such as Building or Water/Sewer/Drainage for items not addressed in this letter. A hard copy of this letter is available upon request by the applicant.

Please Notify Plans Examiner By Email When You Have Submitted A Revision. If you originally submit paper plans, revisions must be submitted as paper plans. If you submit online, revisions must be submitted online

END -ZONING CODE REVIEW

NOTE: THIS CONSTITUTES A PLAN REVIEW TO DATE IN RESPONSE TO THE SUBMITTED INFORMATION ASSOCIATED WITH THE ABOVE REFERENCED APPLICATION. ADDITIONAL ISSUES MAY DEVELOP WHEN THE REVIEW CONTINUES UPON RECEIPT OF ADDITIONAL INFORMATION REQUESTED IN THIS LETTER OR UPON ADDITIONAL SUBMITTAL FROM THE APPLICANT.

KEEP OUR OFFICE ADVISED OF ANY ACTION BY THE CITY OF TULSA BOARD OF ADJUSTMENT OR TULSA METROPOLITAN AREA PLANNING COMMISSION AFFECTING THE STATUS OF YOUR APPLICATION FOR A ZONING CLEARANCE PERMIT.